


CENTER OF GRAVITY:
(DISTANCE FROM DATUM)
X = 3490 mm
Y = -70 mm
Z = 485 mm

NOTE: SLING LOADS INCLUDE 50% EXCESS FOR DYNAMIC LOADINGS.

1. APPROX. SHIPPING LIFTING WEIGHT W/O DYNAMIC LOADING: 37,600 kg
INCLUDES: EQUIPMENT, STEEL, CONCRETE, PIPING
2. APPROX. SHIP LOOSE WEIGHT: 13,140 kg
INCLUDES: COOLER, COOLER PIPING, SURE TANK & SUPPORT, SILENCER & STACK, SILENCER SUPPORT, EXHAUST SUPPORT, EXHAUST PIPING, AND WCP's.

SHIPPING DIMENSIONS

WIDTH: 4160mm
LENGTH: 8655mm
HEIGHT: 3130mm

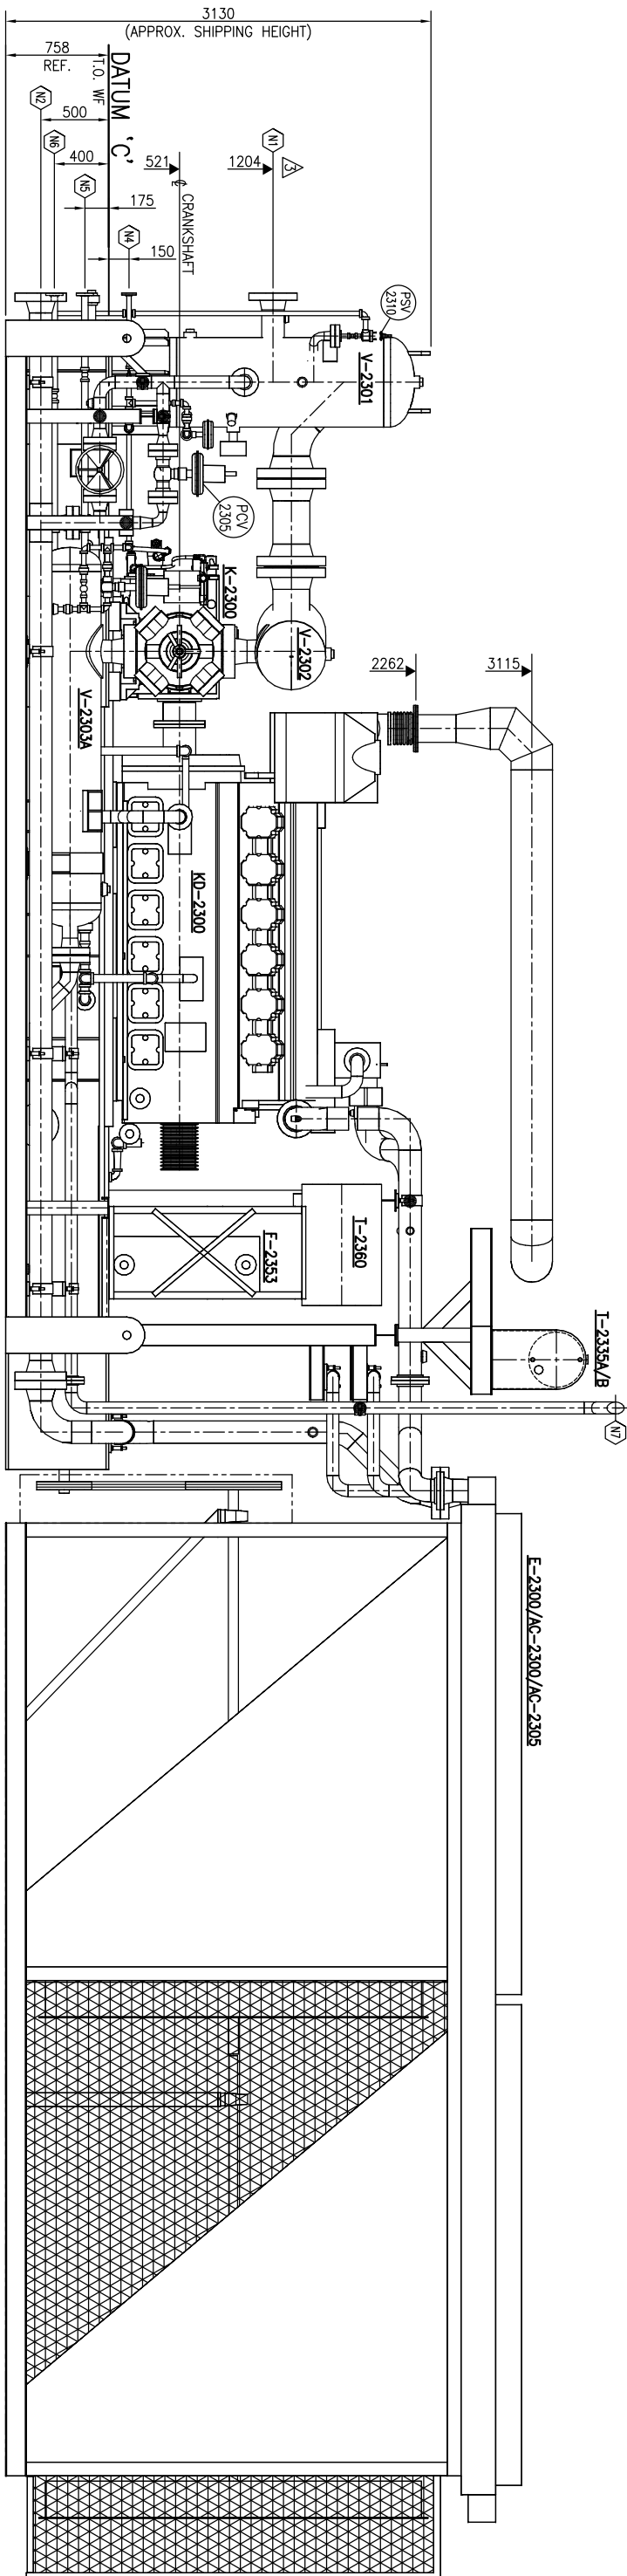

ELEVATION VIEW 'A-A'

CLAMPING LEGEND

● DENOTES HEAVY DUTY CLAMP

<div><div>PROPAK</div><div>440 East Lake Road, Airdrie, Alberta Canada T4A 2U8</div></div>									
YFPB TRANSPORTE S.A.									
SICA SICA STATION LAYOUT ELEVATION VIEW "A-A"									
APPROVED		DRAWN		DWG. D-ASY-108432-111-61 SH1. 2 OF 5 REV. 3					
MECH. STRUCT.	BY D. REIMER	DATE 10/07/12	CHECKED						
ELECTRICAL	DATE	BY I. BRAGINSKY	LAYOUT						
PROJECT	C. ANDREWS	DATE 10/07/26	DATE						
DATE 10/07/26	SCALE 1:25								
GENERAL NOTES									
1 ISSUED FOR CONSTRUCTION									
2									
3									
AS BUILT									
ADDED LIFTING DIAGRAM. REVERSED PSY-2310 PIPING.									
2									
D.F.R. 10/07/28 B CJA									
D.F.R. 10/07/26 B CJA									
BY DATE CKD ENG									
GENERAL NOTES									
1									
2									
3									
AS BUILT									
ADDED LIFTING DIAGRAM. REVERSED PSY-2310 PIPING.									
2									
D.F.R. 10/07/28 B CJA									
D.F.R. 10/07/26 B CJA									
BY DATE CKD ENG									
GENERAL NOTES									
1									
2									
3									
AS BUILT									
ADDED LIFTING DIAGRAM. REVERSED PSY-2310 PIPING.									
2									
D.F.R. 10/07/28 B CJA									
D.F.R. 10/07/26 B CJA									
BY DATE CKD ENG									