



LISTA DE CORTE				
PZA.	TAM.	LONG.	EXT. 1	EXT. 2
<1>	2"	2960	BISELADO	BISELADO
<2>	2"	2719	BISELADO	BISELADO
<3>	2"	1355	BISELADO	BISELADO
<4>	2"	480	BISELADO	BISELADO
<5>	2"	140	BISELADO	BISELADO


REPRESENTACIÓN 3D

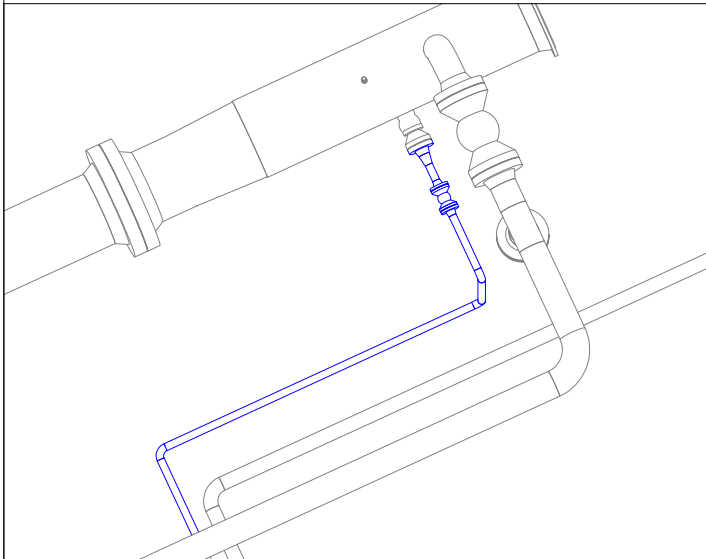

A 3D perspective view of the assembly. It shows a horizontal pipe on the left with a flange, and a vertical pipe on the right. A blue-colored elbow fitting connects the two pipes. The fitting has a threaded end on the vertical pipe and a flanged end on the horizontal pipe. A small black dot is visible on the horizontal pipe near the connection point.

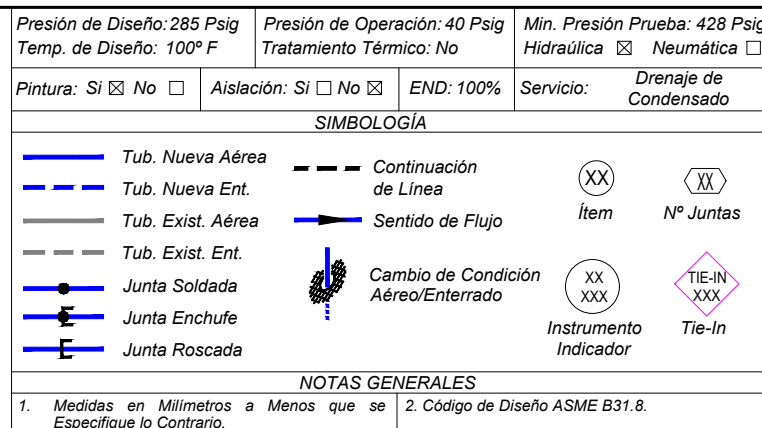

GERENTE DE PROY.: Ivan Meneses	
REVISOR 1:	Jafeth Acha
REVISOR 2:	Felix Zarate
REVISOR 3:	Walter Escobar
CONTRATISTA	
GERENTE DE PROY.: Franklin Argandoña	
REVISOR 1:	Wilbert Mendez
REVISOR 2:	Jorge Togo
REVISOR 3:	Rudy Monasterio

02/Sep/24	R. Mendoza	R. Monasterio	J. Togo	F. Argandoña	1	Conforme a Obra	Bolinter Ltda.
07/May/24	B. Sandóval	R. Monasterio	W. Chávez	F. Argandoña	0	Aprobado para Construcción	Bolinter Ltda.
FECHA	DIBUJO	Calidad REVISOR	Técnico	APROBÓ	REV.N°	DESCRIPCIÓN	EMPRESA
 Transporte S.A.						Ubicación: Colpa - Belgica (SCZ)	
						Etapa: Conforme a Obra	
Proyecto:						Escala:	
Ingeniería y Construcción para el proyecto Estación de Compresión Colpa Fase I						S/E	
Título del Plano:						Formato:	
Isométrico 2"-0.218-B(D-1)-9021 Sistema de Drenaje de Condensado						Tabloide: 279 mm x 432 mm	