THIS DRAWING AND THE DESIGN IT COVERS ARE CONFIDENTIAL AND THE PROPERTY OF PROPAK SYSTEMS LTD., AND SHALL NOT BE DISCLOSED TO OTHERS OR REPRODUCED IN ANY MANNER OR USED FOR ANY PURPOSE WHATSOEVER EXCEPT BY WRITTEN CONSENT OF PROPAK.

N

DESIGN NORTH

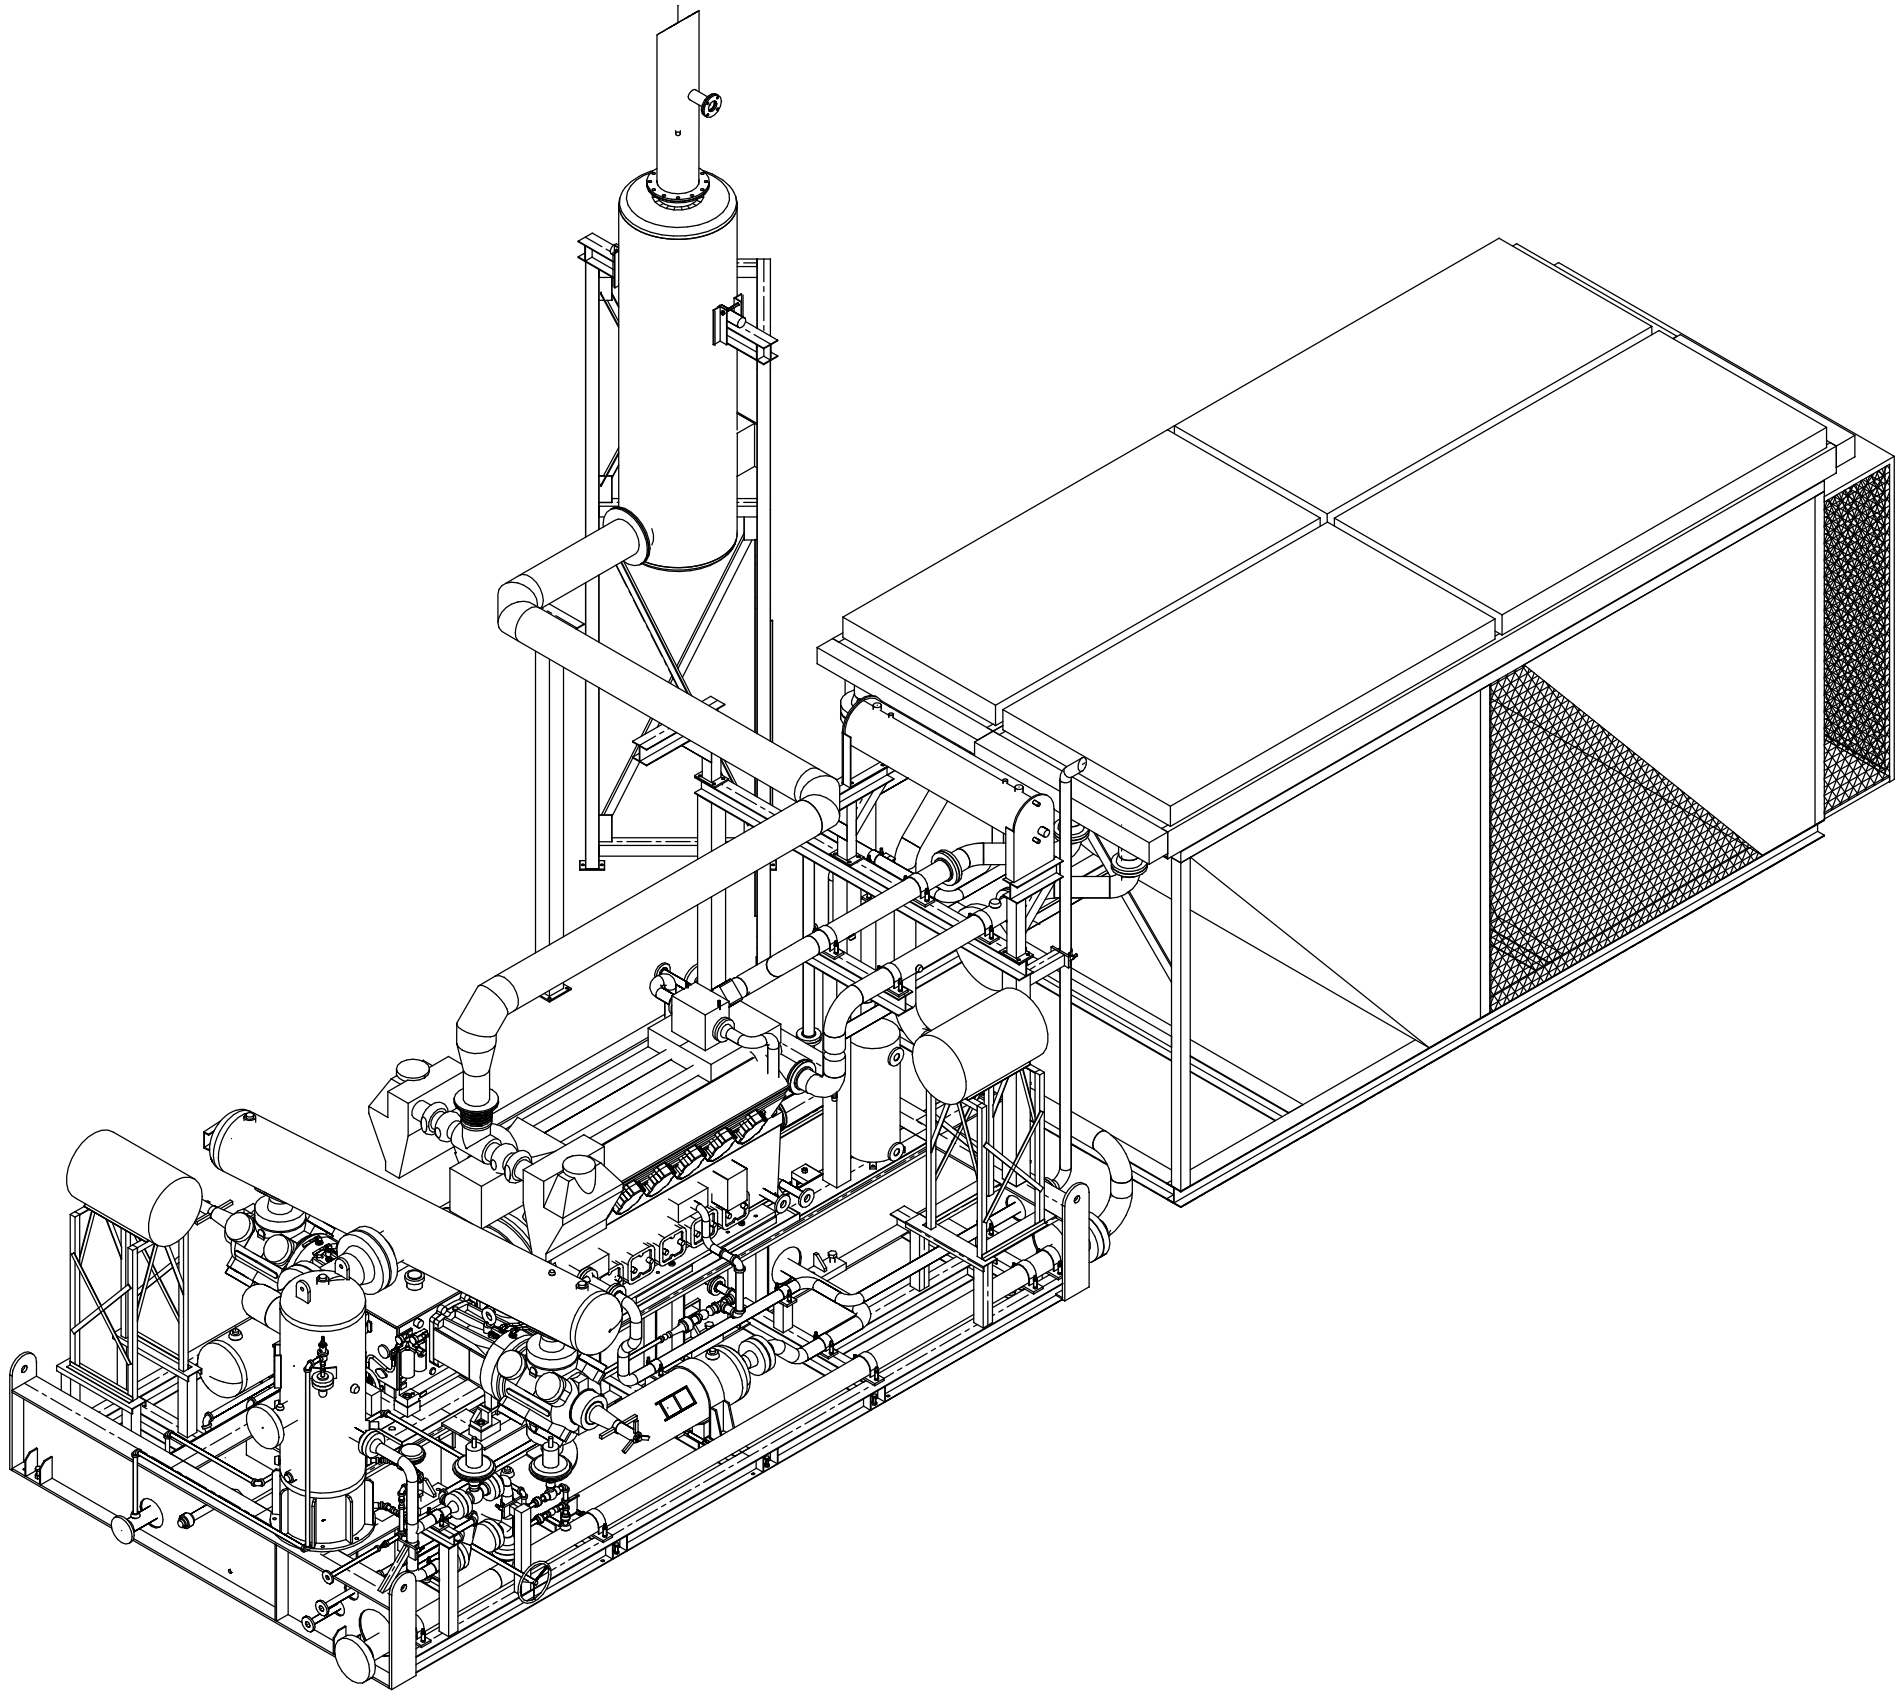

–								APPROVED		DRAWN		YPFB TRANSPORTE S.A.	PROPAK
								MECH./STRUCT.		BY	D. REIMER		440 East Lake Road, Airdrie, Alberta Canada T4A 2J8
								DATE		DATE	10/07/12	SICA SICA STATION	
								ELECTRICAL		CHECKED		LAYOUT	
								DATE		BY	I. BRAGINKSY	ISOMETRIC VIEW (VIEWED FROM SOUTHWEST)	
		2	AS BUILT	L.M.	10/10/20	R.F.	C.J.A.	PROJECT	C. ANDREWS	DATE	10/07/26		
GENERAL NOTES	GENERAL NOTES	1	ISSUED FOR CONSTRUCTION	D.R.	10/07/26	IB	CJA	DATE	10/07/26			DWG. No.: D–ASY–108432–111–61 SHT. 5 OF 5	REV. 2
DATE: 2010/10/20 03:26 PM J:\JOBS10\108432\20-DRAWINGS\FAB\ASY\ASY-108432-111-61-ASBUILT.DWG lmartin		No.	REVISION	BY	DATE	CKD	ENG			SCALE	1:30		